


OPTICAL DISTRIBUTION NETWORK — AS-BUILT PLANT RECORD

DRAWING ODN-FDH14-R3

FIBRE DISTRIBUTION HUB FDH-14 ARDWICK EXCHANGE (ARD-01), OLT-3 PON PORT 1/1/4 GIGABIT PASSIVE OPTICAL NETWORK, 1490 nm DOWNSTREAM

AS-BUILT SHEET 1 OF 1

SCHEMATIC

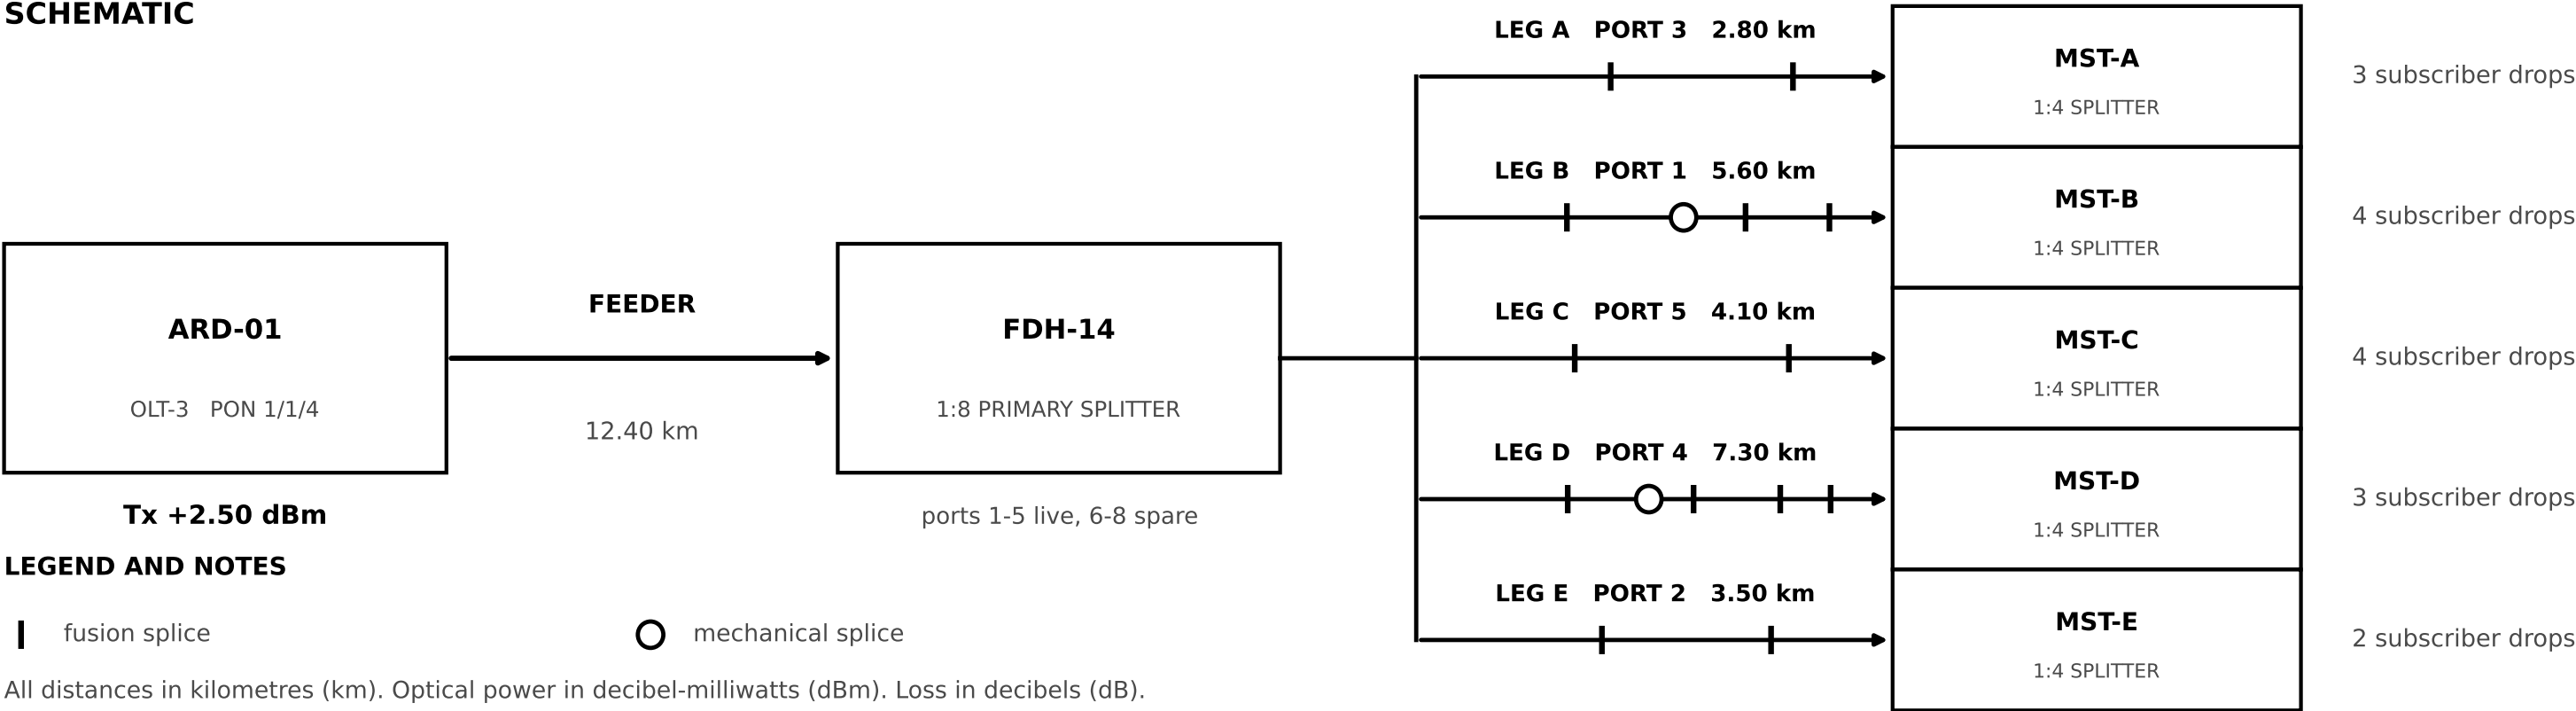

All distances in kilometres (km). Optical power in decibel-milliwatts (dBm). Loss in decibels (dB).

Mated connector pairs per subscriber path: 6 (2 feeder, 2 distribution, 2 drop).

OLT optical line terminal. FDH fibre distribution hub. MST multiport service terminal. ONT optical network terminal.

FDH-14 PRIMARY SPLITTER — CERTIFIED PORT INSERTION LOSS

This 1:8 splitter is individually certified. The insertion loss of the port feeding a leg is the value that applies to that leg.

PORT 1	PORT 2	PORT 3	PORT 4	PORT 5	PORT 6	PORT 7	PORT 8
10.62 dB	10.28 dB	10.35 dB	10.81 dB	10.44 dB	10.19 dB	10.55 dB	10.73 dB

SEGMENT RECORD

SEGMENT	FDH PORT	LENGTH (km)	FUSION	MECH	CONN
Feeder, ARD-01 to FDH-14	—	12.40	5	0	2
Distribution Leg A, FDH-14 to MST-A	3	2.80	2	0	2
Distribution Leg B, FDH-14 to MST-B	1	5.60	3	1	2
Distribution Leg C, FDH-14 to MST-C	5	4.10	2	0	2
Distribution Leg D, FDH-14 to MST-D	4	7.30	4	1	2
Distribution Leg E, FDH-14 to MST-E	2	3.50	2	0	2
Drop, MST to ONT	—	per subscriber	0	0	2

SPLICE SCHEDULE, DISTRIBUTION LEGS

Distances are measured from the FDH-14 output port, the 0.00 km datum.

LEG	DIST (km)	SPLICE TYPE
A	1.10	Fusion
A	2.35	Fusion
B	1.60	Fusion
B	3.20	Mechanical
B	4.05	Fusion
B	5.20	Fusion
C	1.25	Fusion
C	3.40	Fusion

LEG	DIST (km)	SPLICE TYPE
D	2.10	Fusion
D	3.55	Mechanical
D	4.35	Fusion
D	5.90	Fusion
D	6.80	Fusion
E	1.30	Fusion
E	2.75	Fusion